
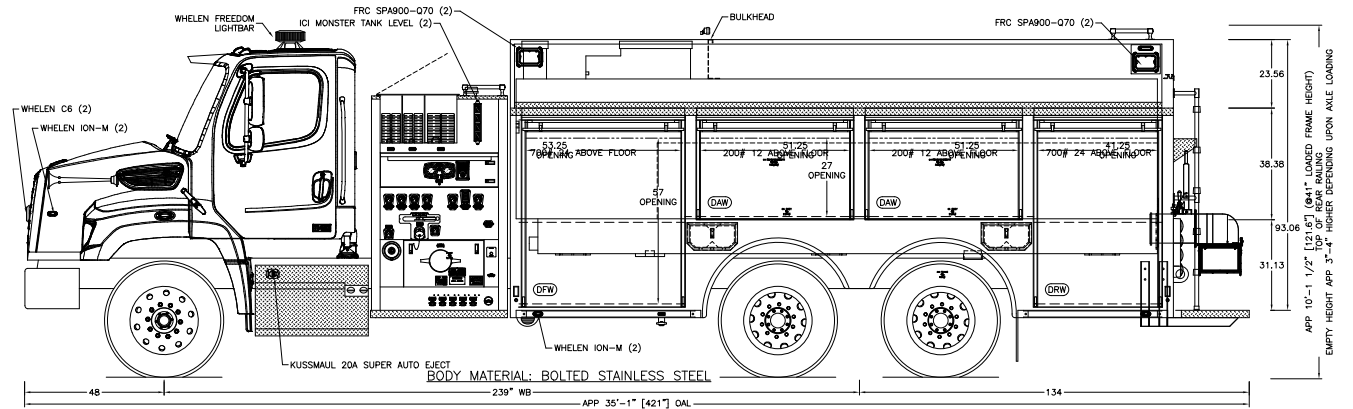
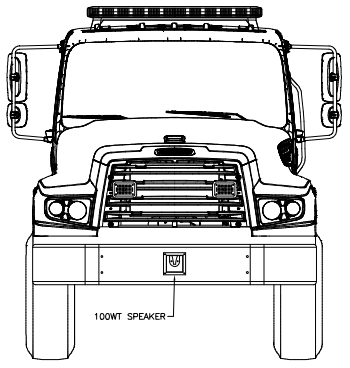


TREADBRITE TEXTURE NOT SHOWN IN TOP VIEW

REFERENCE SCALE IN INCHES
 0 10 20 30 40

COMP.	HEIGHT	WIDTH	USABLE DEPTH		DIVIDE	FT.
			UPPER	LOWER	HEIGHT	
DFW	67.12	59.88	14	26	28	44.20
DAW (2)	37.12	59.75	14	-	-	17.98
DRW	67.12	44.00	14	26	28	32.49
PFW	36.62	59.88	10	26	28	28.20
FRW	36.62	44.00	10	26	28	20.72
HOSEBED	12	72	-	-	160	60.00
FRONT XLAY	16	7.5	-	-	73.75	5.12
MIDDLE XLAY	16	7.5	-	-	73.75	5.12
REAR XLAY	16	11	-	-	73.75	7.51

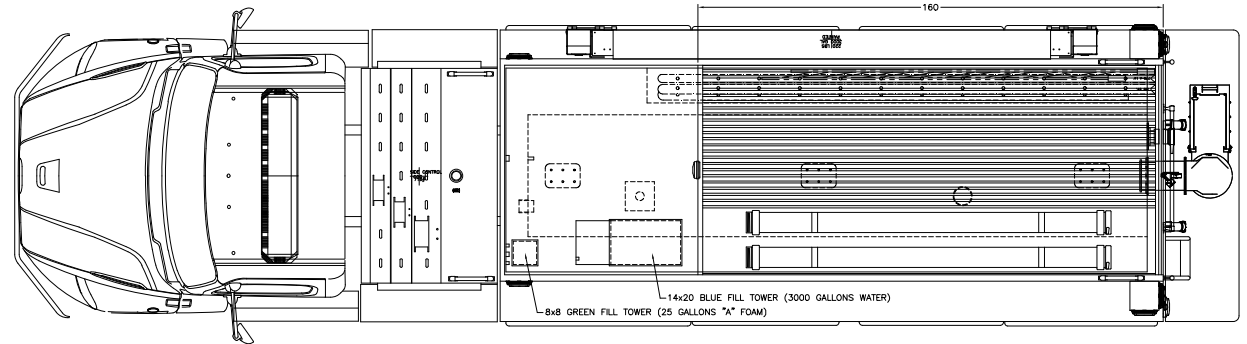

NOTE:
 DIMENSIONS SHOWN ARE APPROXIMATE AND ARE SUBJECT TO MINOR CHANGE AS MAY BE FOUND NECESSARY DURING CONSTRUCTION. MINOR DETAILS MAY NOT BE SHOWN. IF DISCREPANCIES EXIST BETWEEN THIS DRAWING AND THE WRITTEN SPECIFICATIONS PROVIDED BY TOYNE, THE WRITTEN SPECIFICATIONS SHALL PREVAIL.

ORIGINAL DRAWING	24FEB22	CHASSIS:	FREIGHTLINER SD114SBA 2 DOOR 6x4	SCALE:	1/66	SHEET:	A
AS BUILT:	AK	WB-CA-AF:	239"-173.4"-107" D17	CITY:	--		
		BODY MATL:	BOLTED STAINLESS STEEL	STATE:	--		
		PUMP:	HALE QMAX 1250	DLR:	TOY		
		TANK:	3000/25 UPF POLY-TANK III	CAD:	GROSSMAN		
		FOAM SYSTEM:	PRE-PIPE	DATE:	24 FEBRUARY 2022		
		GENERATOR:	N/A	FILE:	13297DEMO		

BREA, IA 51436
 800-648-3358
 WWW.TOYNE.COM

DEMO
 CUSTOM PUMPER