

SARATOGA COUNTY HAZMAT
RESCUE
TID NO. 13935



BODY

- Welded Stainless Steel Body
- ROM Roll Up Doors
- Upper Body Coffin Compartments
- Rear Mounted Ladder for Easy Upper Body Access
- Storage for 11 SCBA Bottles in Wheel Wells
- Custom Storage Drawers
- Roll-Out Storage Trays and Toolboards
- (2) Electric Retractable Awnings



TANK

- None



PUMP

- None



ELECTRICAL




- Harrison 10,000 Watt Generator
- Whelen Warning Lighting
- Whelen LED Arrowstick
- Whelen Summit S72MW Light Tower
- Whelen PCPSM2C Scene Lights on Body
- Whelen PCPSM1B Scene Lights on Cab
- Electric Cord Reel
- Wilburt Light Tower
- ILI LED Strip Compartment Lighting



CHASSIS

- Spartan Metro Star LFD with 20" Raised Roof
- Cummins ISL9 450 HP Engine
- 3000 EVS Transmission
- Seating for 6 Firefighters
- Back-Up Camera
- Internal and External EMS Compartments

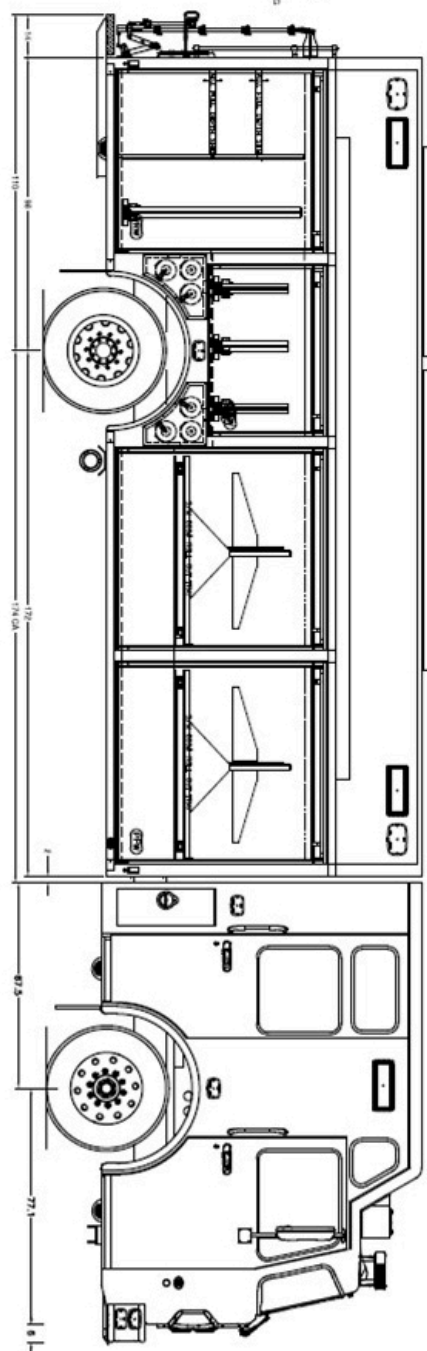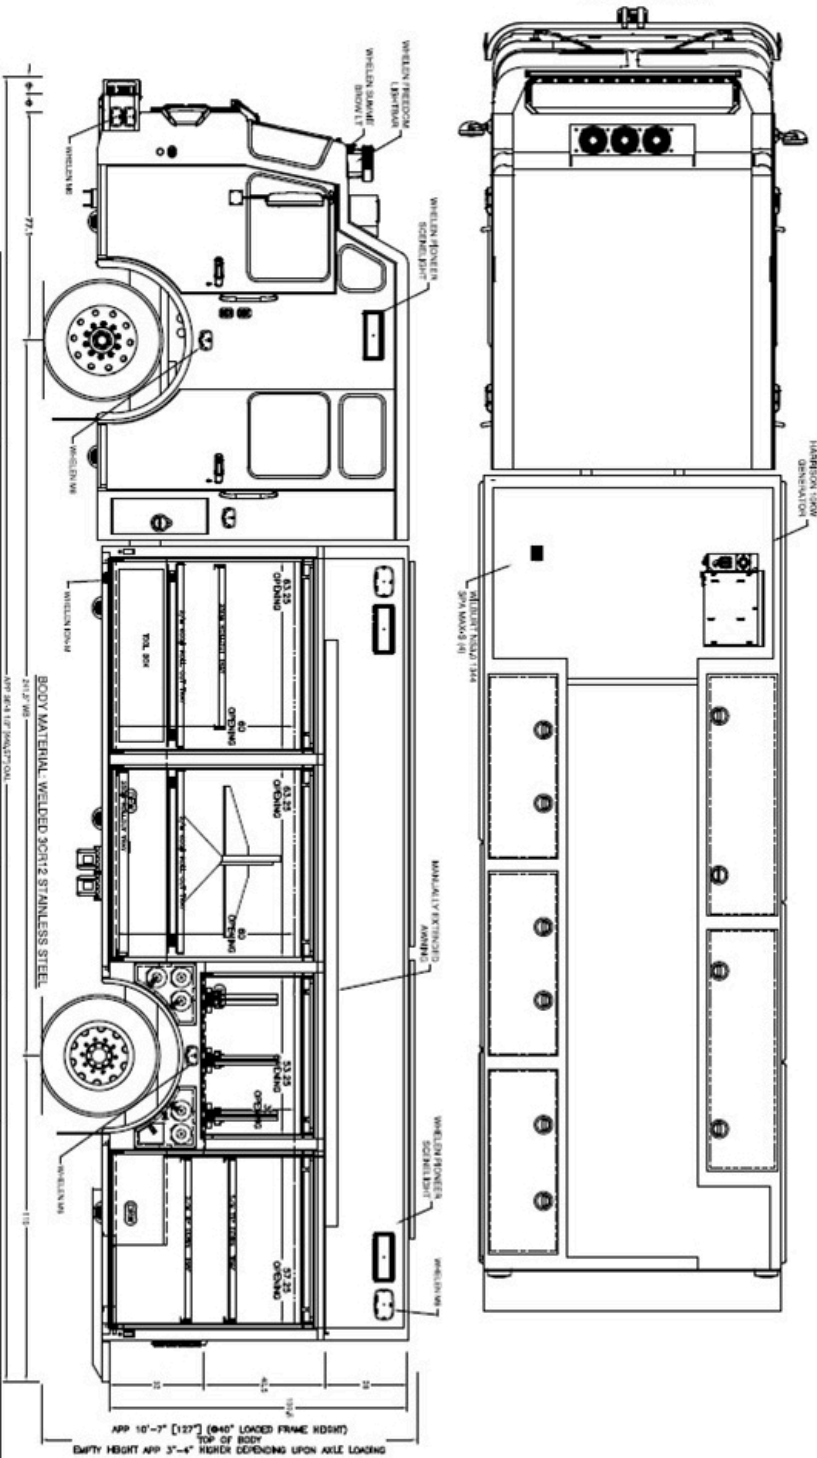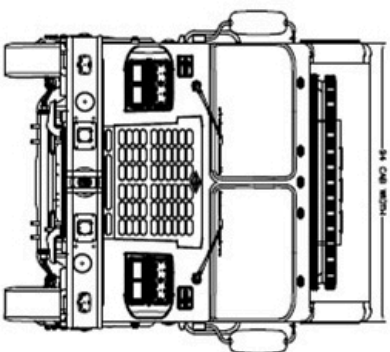

[illegible]

NOTE:
DIMENSIONS SHOWN ARE APPROXIMATE AND ARE SUBJECT TO MINOR CHANGE AS MAY BE FOUND NECESSARY DURING CONSTRUCTION. MINOR DETAILS MAY NOT BE SHOWN. IF DISCREPANCIES EXIST BETWEEN THIS DRAWING AND THE WRITTEN SPECIFICATIONS PROVIDED BY TOWNE, THE WRITTEN SPECIFICATIONS SHALL PREVAIL.

ORIGINAL DRAWING	21APR23	CHASSIS	SPARTAN MOTORISTAR LTD 20" RR	SCALE: 1/66	SHEET: 1
BSR	29JUN23	WB-COA-F:	241.5"-174'-63" D17	STATE: -	
UPDATE	15AUG23	BODY MATL:	WELDED STAINLESS STEEL	CITY: -	
CO I	13SEP23	PUMP:	N/A	DLR: VRS	
AS BUILT: ANDY	08JAN25	TANK:	N/A		
		FOAM SYSTEM:	N/A		
		GENERATOR:	HARRISON 10KW HYDRAULIC		
		FILE:	SARATOGARC93		



Toyne
Shift to solve the cost.
BREDA, IA 51436
800-648-3358
WWW.TOYNE.COM

SARATOGA
WALK AROUND RESCUE